

PREPARED BY:  
**SEEK ARCHITECTURE**  
 ERIC BROOKS 425-681-1596

12/3/2015 1

**SCHEMATIC**

NOT FOR  
 CONSTRUCTION

JURISDICTION APPROVAL SPACE

**AS BUILT PLANS**

**HARNER-JAY RESIDENCE**

8245 SE 59TH STREET  
 MERCER ISLAND, WA 98040

**A104**


#

**AS BUILT PLAN LEGEND**

- EXISTING CONCRETE WALL TO REMAIN
- EXISTING FRAMED WALL TO REMAIN
- ELEMENTS TO BE REMOVED
- HIDDEN ELEMENT
- OVERHEAD ELEMENT

**AS BUILT PLAN NOTES**

1. ALL DIMENSIONS ARE TO FACE OF FRAMING.
2. CONTRACTOR TO VERIFY ALL EXISTING FIELD CONDITIONS PRIOR TO COMMENCING WORK.

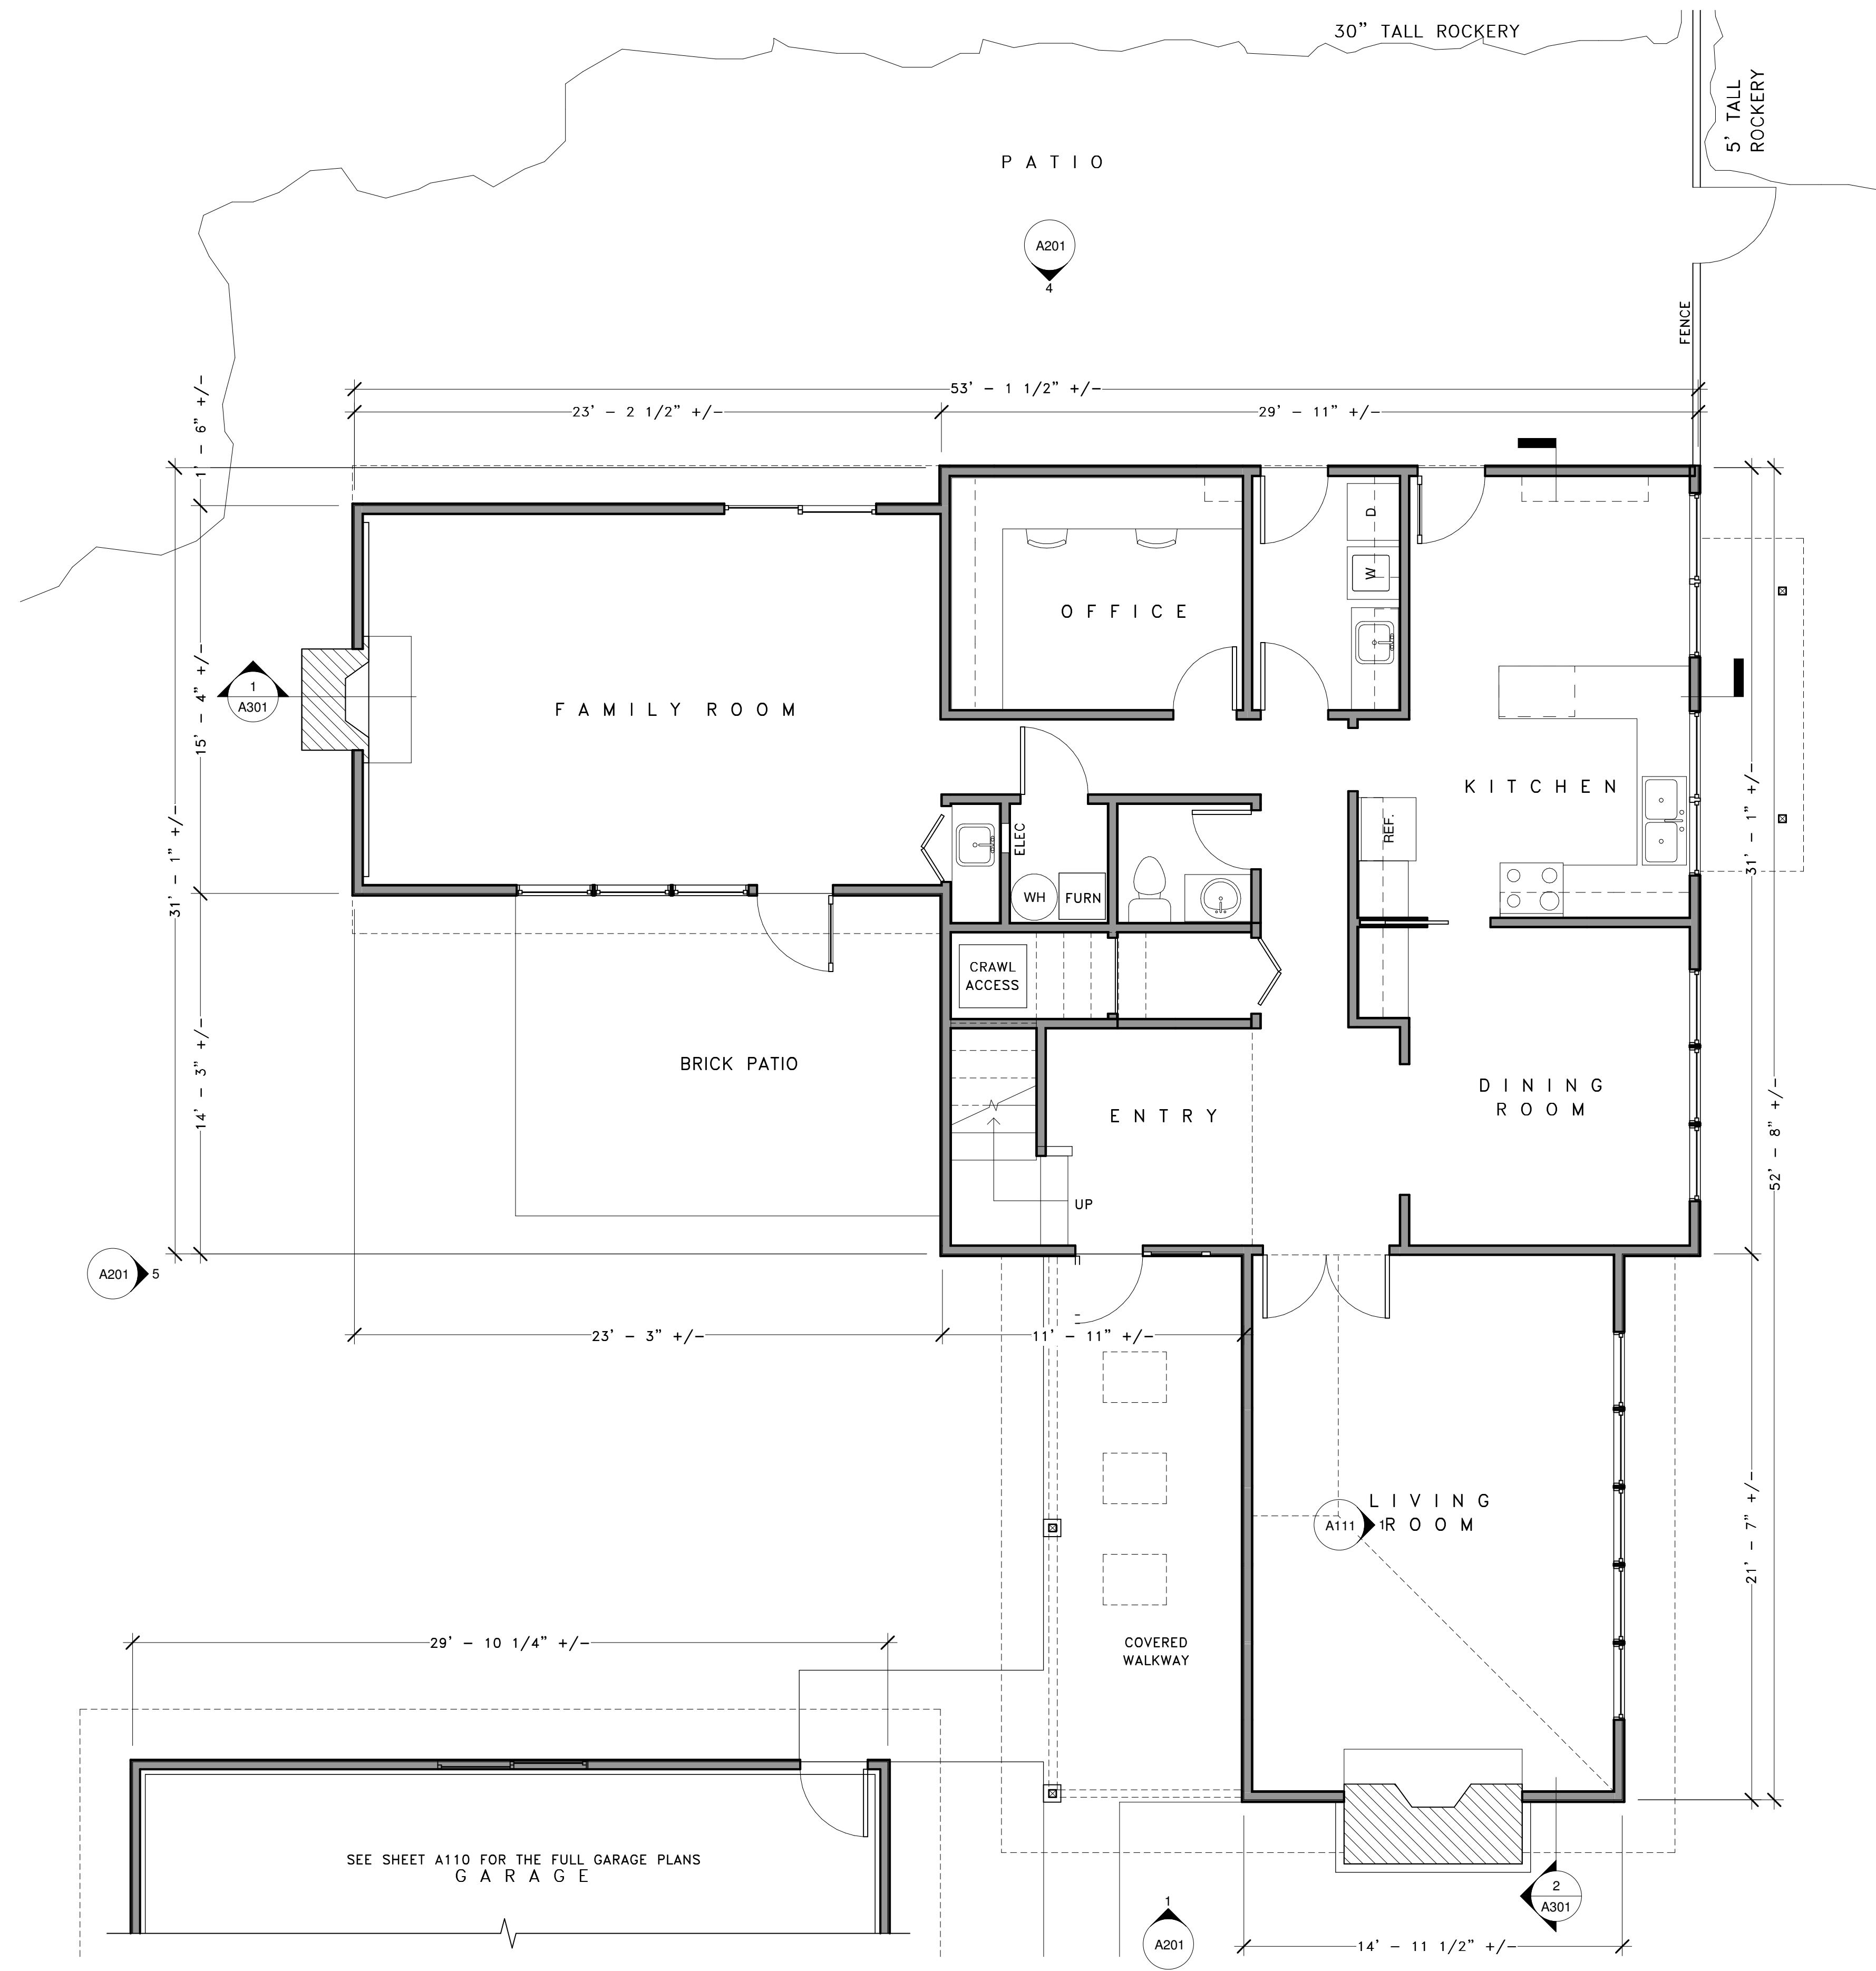

**1 AS BUILT GROUND FLOOR PLAN**  
 1/4" = 1'-0"

